



21650

WARNER CENTER TOWER - III

SUITE 1420 | 7,694 RSF

WOODLAND HILLS

OXNARD STREET

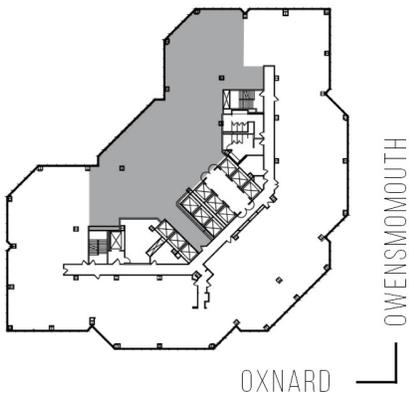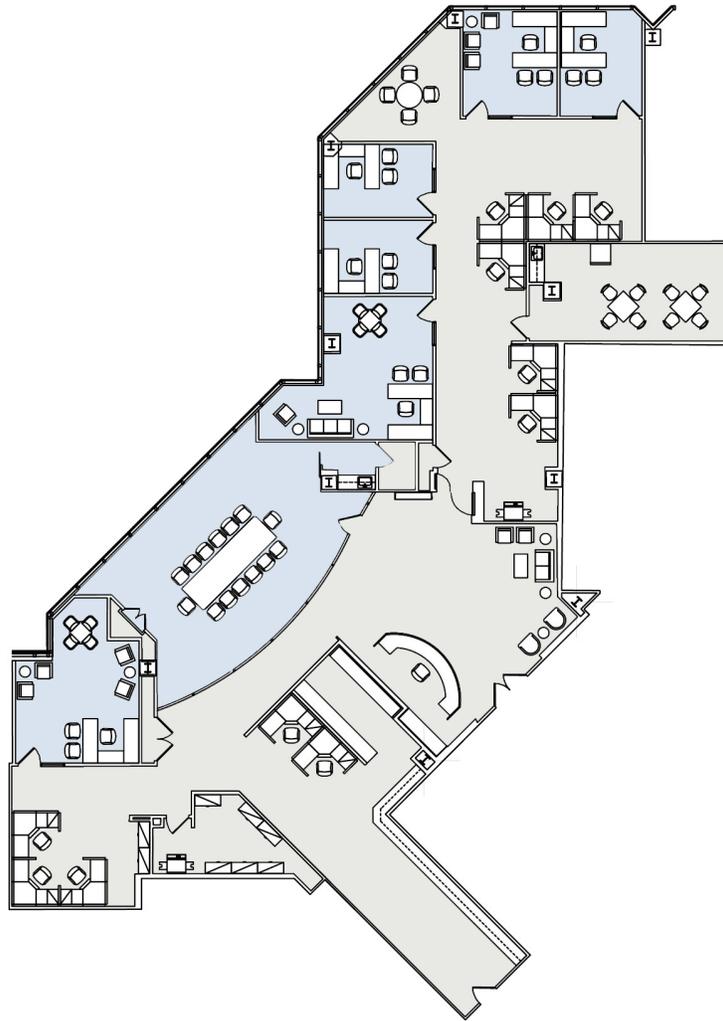

AS-BUILT CONFIGURATION

OFFICES:	6
RECEPTION:	1
CONFERENCE ROOM:	1
KITCHENS:	2
UTILITY/COPY ROOM:	1
STORAGE CLOSETS:	4

NOT TO SCALE  
FURNITURE NOT INCLUDED

For more information, please contact:

310.255.7777  
leasing@douglasemmett.com

**Douglas  
Emmett**