


21650 OXNARD

WARNER CENTER TOWER 3

SUITE 1700 | 10,525 RSF
WOODLAND HILLS

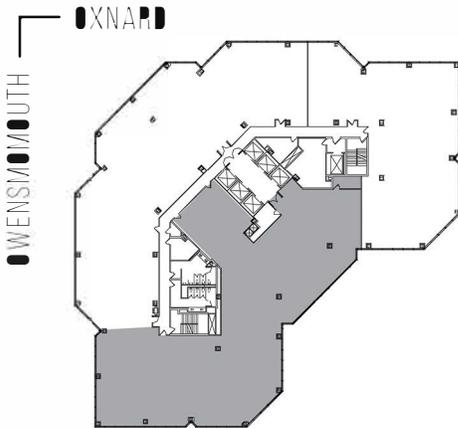

AS-BUILT CONFIGURATION

OFFICES:	11
CONFERENCE ROOMS:	1
RECEPTION:	1
KITCHEN:	1
SERVER ROOM:	1
STORAGE ROOMS:	2

NOT TO SCALE
FURNITURE NOT INCLUDED

For more information, please contact:

HAYLEY BLOCKLEY
213.239.6054
hayley_blockley@am.jll.com

JIM LINDVALL
818.531.9678
jim.lindvall@am.jll.com

