



21650

WARNER CENTER TOWER - III

SUITE 1000 | 25,586 RSF

WOODLAND HILLS

OXNARD STREET

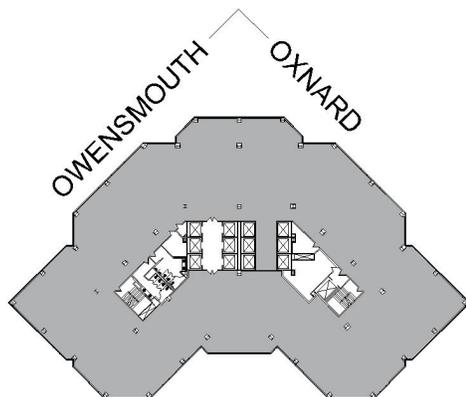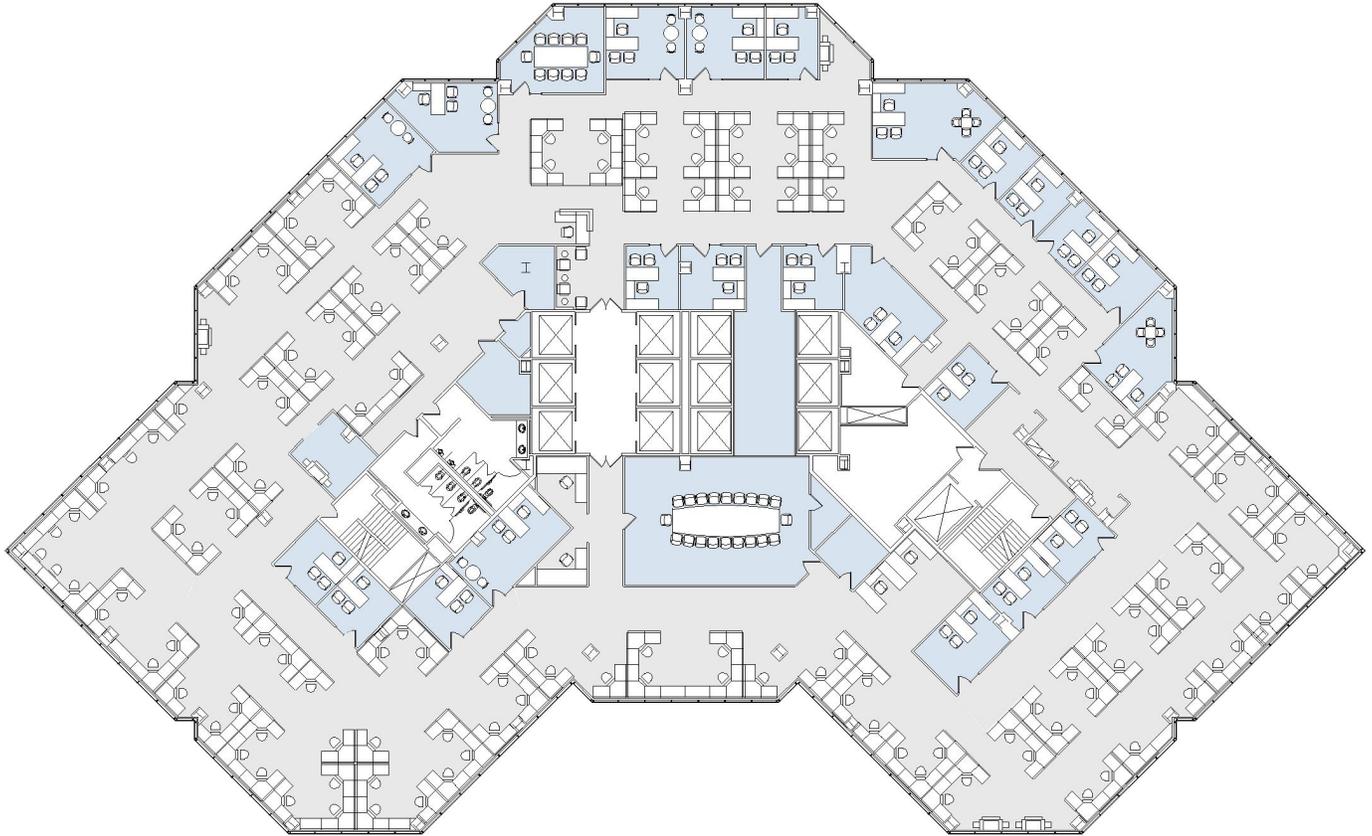

AS-BUILT CONFIGURATION

OFFICES:	23
CONFERENCE ROOM:	2
RECEPTION:	1
STORAGE:	4
IT ROOM:	1
FILE ROOM:	1

NOT TO SCALE

FURNITURE NOT INCLUDED

For more information, please contact:

310.255.7777
leasing@douglasemmett.com

**Douglas
Emmett**