
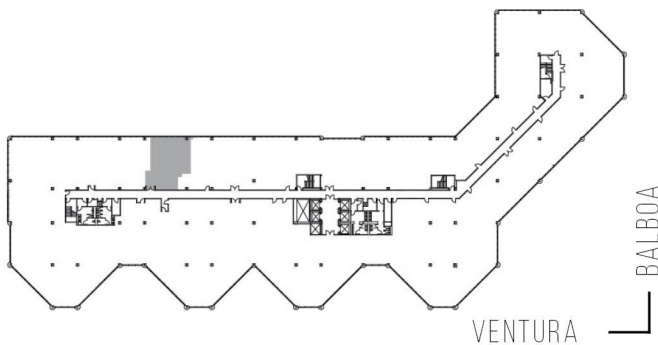


# 16830 VENTURA

FIRST FINANCIAL PLAZA

SUITE 355 | 1,427 RSF

SHERMAN OAKS/ENCINO

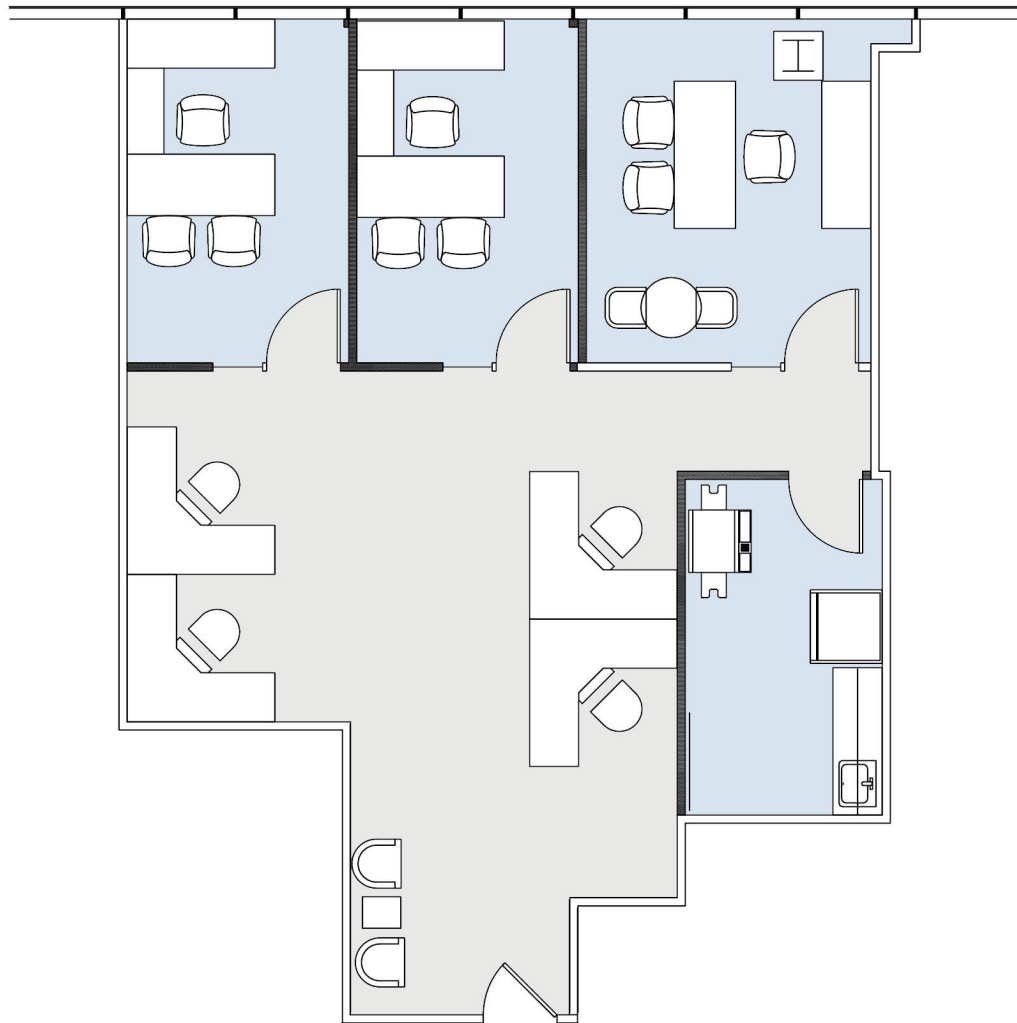

### AS-BUILT CONFIGURATION

OFFICES:	3
BREAK ROOM:	1
RECEPTION:	1

NOT TO SCALE  
FURNITURE NOT INCLUDED

For more information, please contact:

310.255.7777  
leasing@douglasemmett.com

**Douglas  
Emmett**