


429

SUITE 250 | 6,150 RSF

SANTA MONICA

SANTA MONICA

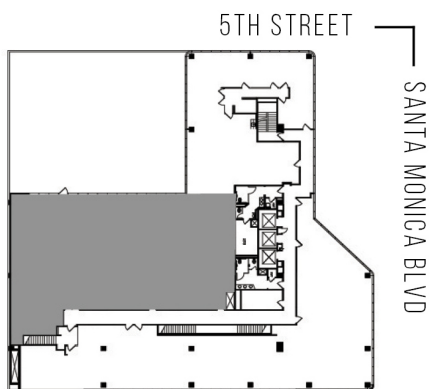

AS-BUILT CONFIGURATION

OFFICES:	8
CONFERENCE ROOMS:	2
RECEPTION:	1
WAITING ROOM:	1
KITCHEN:	1
I.T./ COPY ROOM:	1
STORAGE CLOSET:	1
FILE ROOM:	1

NOT TO SCALE
FURNITURE NOT INCLUDED

For more information, please contact:

310.255.7777
leasing@douglasemmett.com

**Douglas
Emmett**