


1990

CORNERSTONE PLAZA

SUITE 200 | 16,214 RSF

SAWTELLE/WEST LA

SOUTH BUNDY

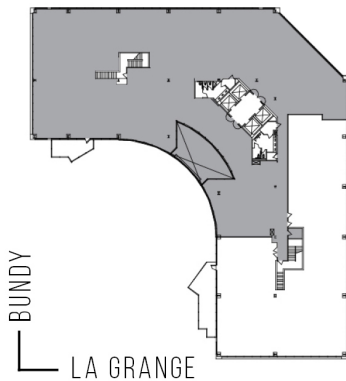

AS-BUILT CONFIGURATION

OFFICES:	31
CONFERENCE ROOMS:	3
RECEPTION:	1
KITCHEN:	1
SERVER ROOM:	1
STORAGE ROOMS:	5
FILE ROOM:	1
STORAGE CLOSETS:	2
DELIVERY VESTIBULE:	1

ADJUSTED FOR SOCIAL DISTANCING
NOT TO SCALE
FURNITURE NOT INCLUDED

For more information, please contact:

310.255.7777
leasing@douglasemmett.com

**Douglas
Emmett**