


# 21300 VICTORY

WARNER CORPORATE CENTER

SUITE 300 | 22,302 RSF

WOODLAND HILLS

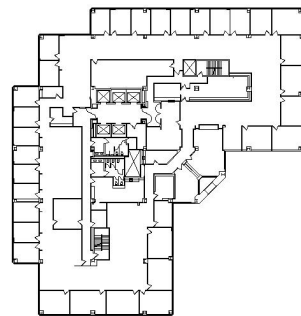

#### AS-BUILT CONFIGURATION

OFFICES:	34
CONFERENCE ROOM:	3
RECEPTION:	1
KITCHEN:	2
STORAGE:	4
BREAK ROOM:	1

ADJUSTED FOR SOCIAL DISTANCING  
NOT TO SCALE  
FURNITURE NOT INCLUDED

For more information, please contact:

310.255.7777

leasing@douglasemmett.com

**Douglas  
Emmett**