


530 WILSHIRE

VERONA

SUITE 310 | 2,252 RSF

SANTA MONICA

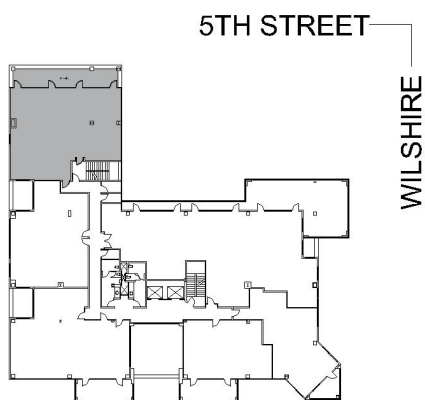

AS-BUILT CONFIGURATION

OFFICES:	4
CONFERENCE ROOM:	1
RECEPTION:	1
KITCHEN:	1
PRIVATE PATIO:	1

NOT TO SCALE

FURNITURE NOT INCLUDED

For more information, please contact:

310.255.7777
leasing@douglasemmett.com

**Douglas
Emmett**