


10990 WILSHIRE

ONE WESTWOOD

SUITE 1175 | 2,264 RSF

WESTWOOD

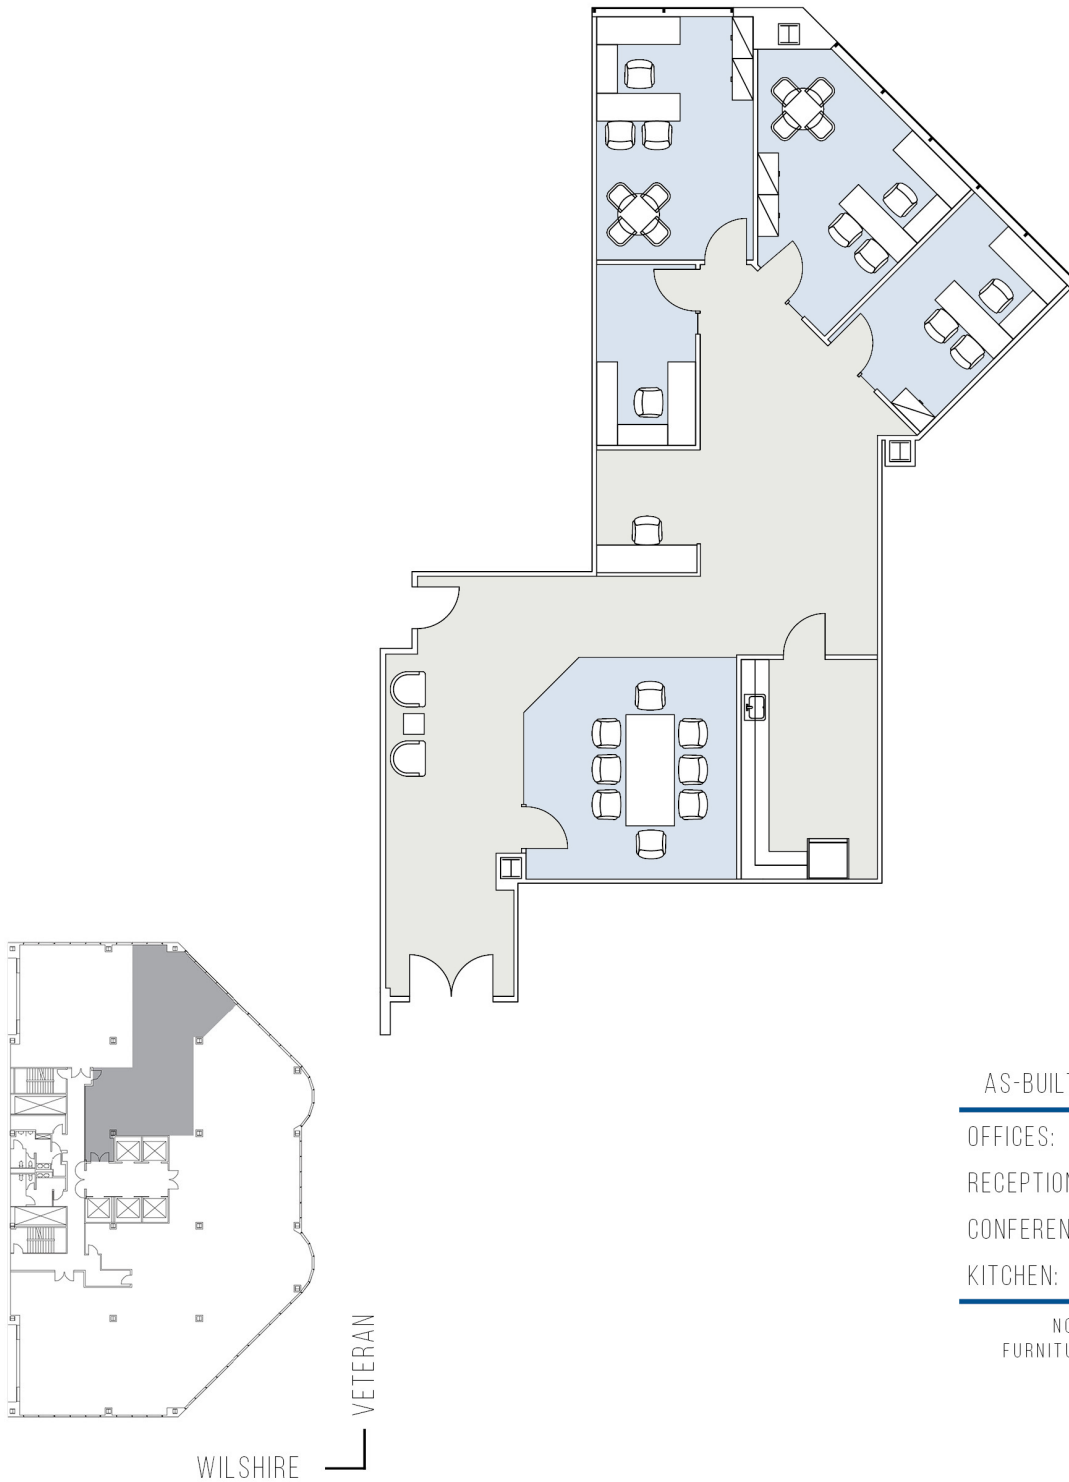

For more information, please contact:

310.255.7777
leasing@douglasemmett.com

**Douglas
Emmett**