


233

# WILSHIRE

SUITE 990 | 8,232 RSF

SANTA MONICA

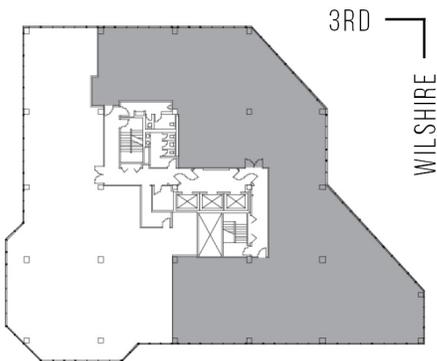

### AS-BUILT CONFIGURATION

OFFICES:	11
CONFERENCE ROOMS:	2
RECEPTION:	1
KITCHENS:	2
PHONE ROOMS:	2

ADJUSTED FOR SOCIAL DISTANCING  
NOT TO SCALE  
FURNITURE NOT INCLUDED

For more information, please contact:

310.255.7777  
leasing@douglasemmett.com

**Douglas  
Emmett**