


21650

WARNER CENTER TOWER - III

SUITE 1950 | 9,555 RSF

WOODLAND HILLS

OXNARD STREET

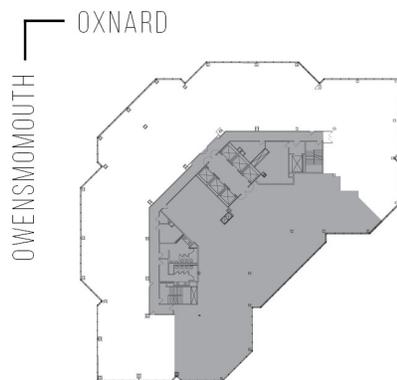

AS-BUILT CONFIGURATION

OFFICES:	18
RECEPTION:	1
CONFERENCE ROOMS:	3
STORAGE ROOMS:	2
COPY ROOM:	1
SERVER ROOM:	1

NOT TO SCALE
FURNITURE NOT INCLUDED

For more information, please contact:

310.255.7777
leasing@douglasemmett.com

**Douglas
Emmett**