21550

OXNARD STREET

WARNER CENTER TOWER - II

SUITE 940 | 2,259 RSF

WOODLAND HILLS

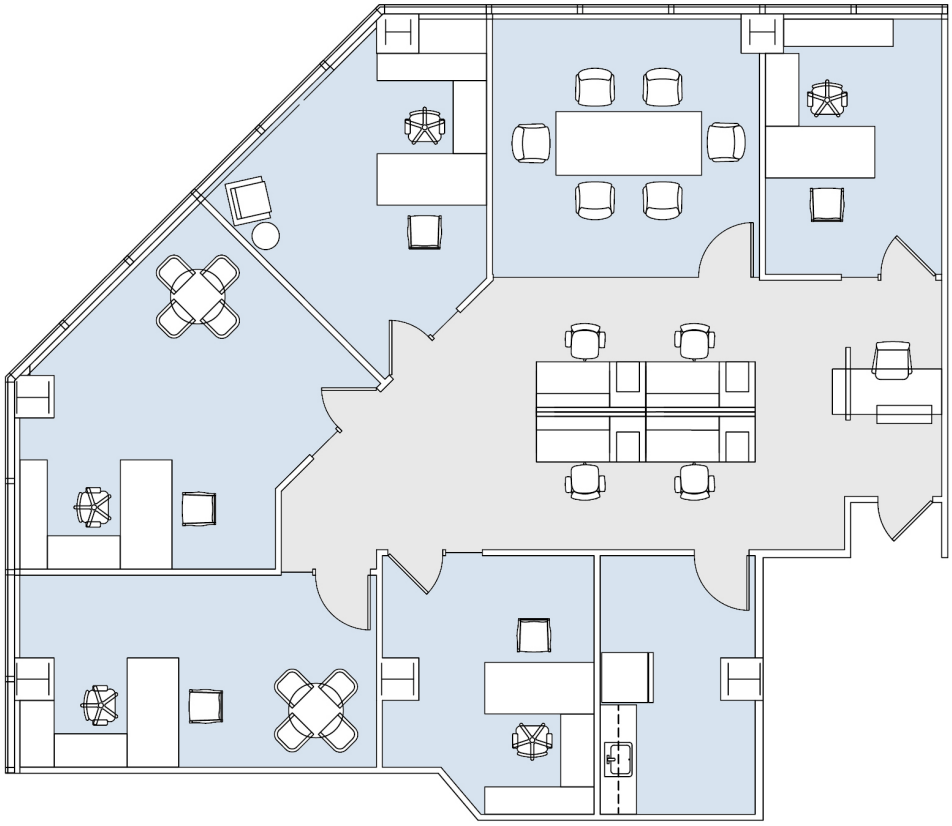

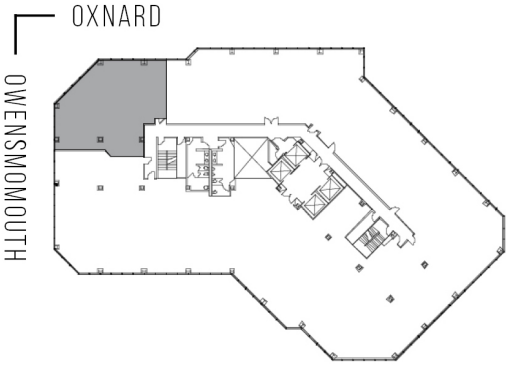

AS-BUILT CONFIGURATION

OFFICES:	5
CONFERENCE ROOM:	1
RECEPTION:	1
KITCHEN:	1

ADJUSTED FOR SOCIAL DISTANCING
NOT TO SCALE
FURNITURE NOT INCLUDED

For more information, please contact:

310.255.7777
leasing@douglasemmett.com

Douglas Emmett